

Borg & Eastwood Dr, 16


4-21-77

sunny

FWM  
Geo. G.  
Larry Levitt

water problem

2100  
- 48  
1752

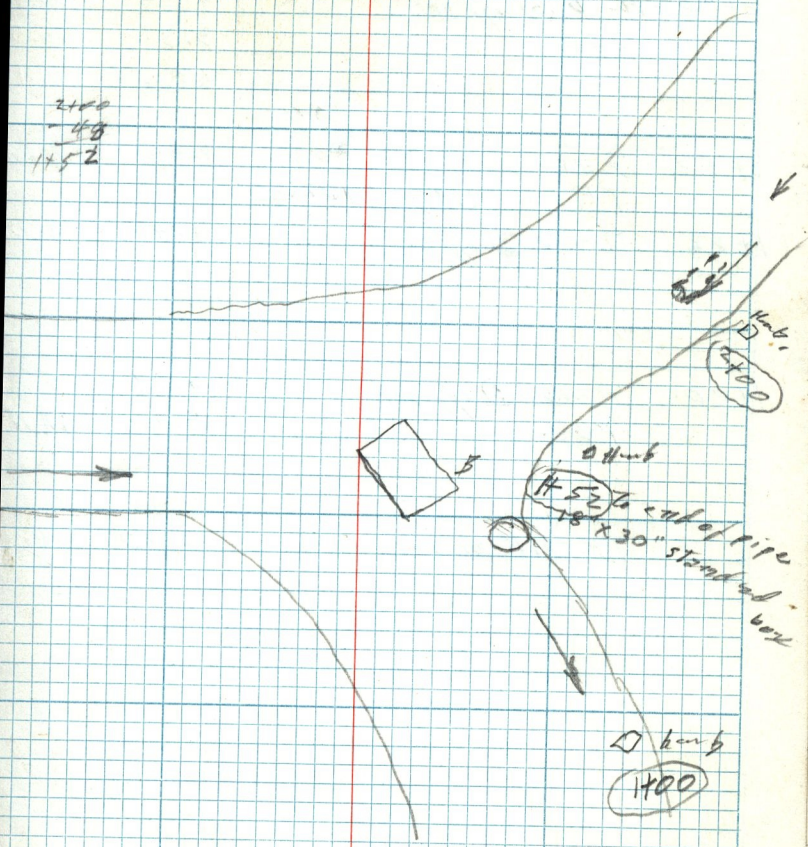

over