


2550 S.

①

LEFT
RIGHT

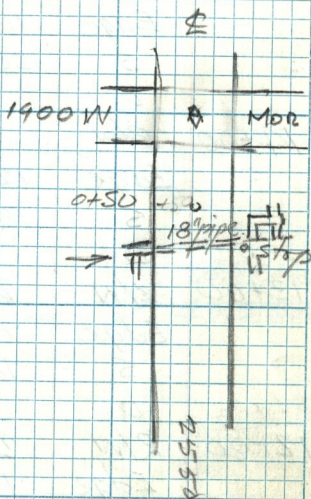

Ditch 25' wide

± 1900 & 2550 Sec. Line