


- 30+44 RR Sign L-24°
- 30+40 E. END of Box R/17° (36" x 24")
- 30+27 E. R.W. of RR.
- 30+19.6 E RR Track (Spur)
- 30+02 - 24" CMP 18' Right

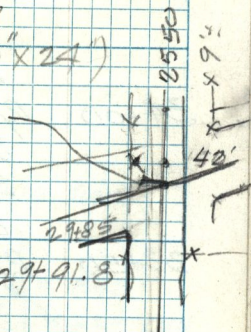

- R.W. on L. West side of Drive. (29+91.8)
- 29+98 RR Sign R. 12°
- 29+91.8 L. West R.W. of tracks
- 29+73.3 T.P. L-29.0

(25+50 N. Potato Celler Rt. L to 25+50
Entrance on R.W. R/W.

- 28+90 R. Valve Box M. Fuel Supply
- 28+53 R. 9.7 RR Sign
- 28+47 Manhole L-27' Shoulder
- 28+256 T.P. L-27.5