


34+16.8 Signal R-15.9

34+09.5 R. W. End 22.3 CMP R. 30"

34+15.8 T. Pole L-28.0

34+09.5 P. Pole R-31.0

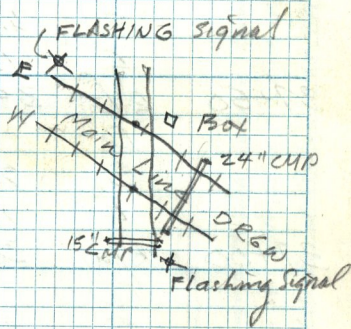

32+47 L. T. Pole 27.3 ✓

31+14.1 RR. Sign R 113 ✓ ✓

30+84 L 268 P. Pole