


53+75.5 END Proj.

53+00 12 gate L-5

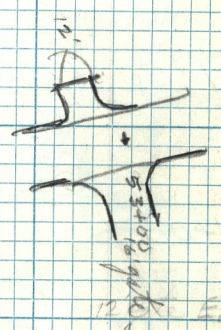

53+05.6

S. Drive

2+84

N. Driveway

L-33.41

2+80.5

N. End Culvert

R-25.7