

2550 S.

H. Young T. Staker (50)
C. Minnich 10/30/73

⊕

- 18" Culvert E. side #1
- Rt Ditch Bottom #2
- Lt. 12" Culvert F. Line
- 5ft 14" Conc. " S. side
- " " " N End

Ditch at Fence

Fence Post

T. Pole


Rail on Fence Line

Signal X Block Concrete

Switch T. Pole # 40.3 35+00

Control/Control Box
X Signal # 34+91.7

35+00

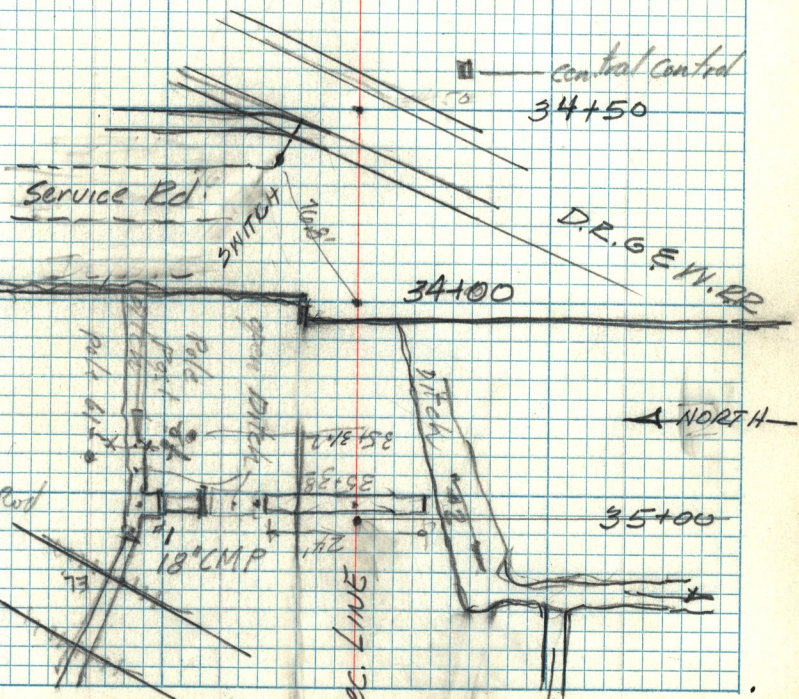

Control Control
34+50

Service Rd.

SWITCH
T. Pole

D.R. 6 F.V. RR

34+00

← NORTH

35+00

18" CMP

Sec. Line

DETAIL AT MAIN LINE