


4  
VCOR 15/14 5X3 W

5100 SOUTH

NAIL ON SEC LINES

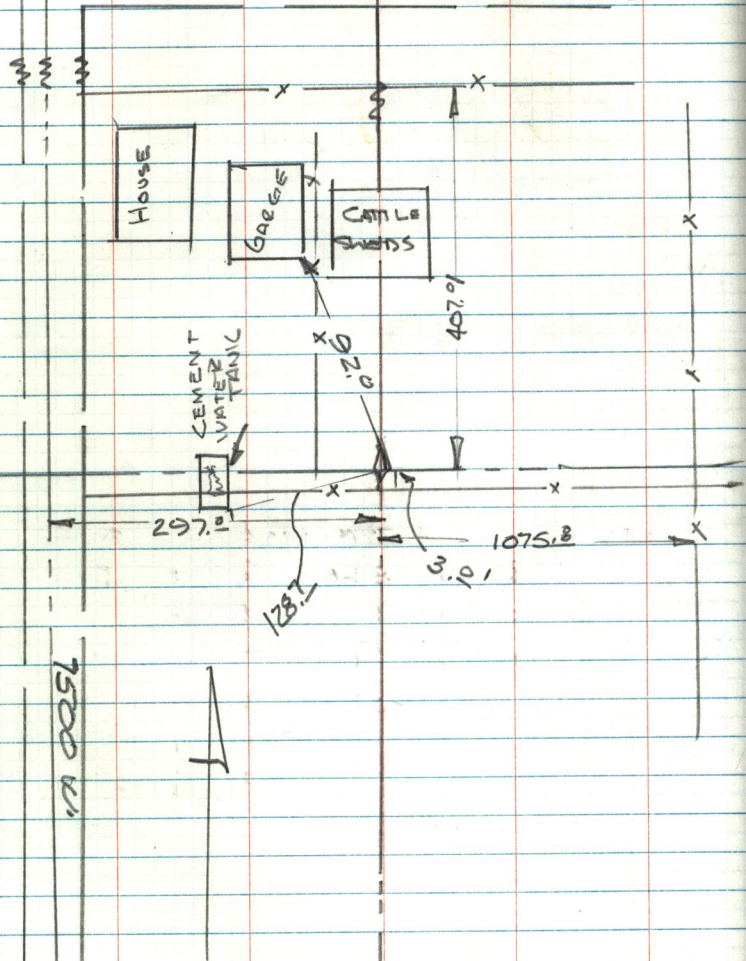

7500 W.



297.0'

128.1'

1075.8'

407.0'

92.0'

House

Garage

CATTLE SHEDS

CEMENT WATER TANK

NAIL ON SEC LINES

5100 SOUTH

4  
VCOR 15/14 5X3 W