


1/4 14/13 T5N, R3W

April 5, 74

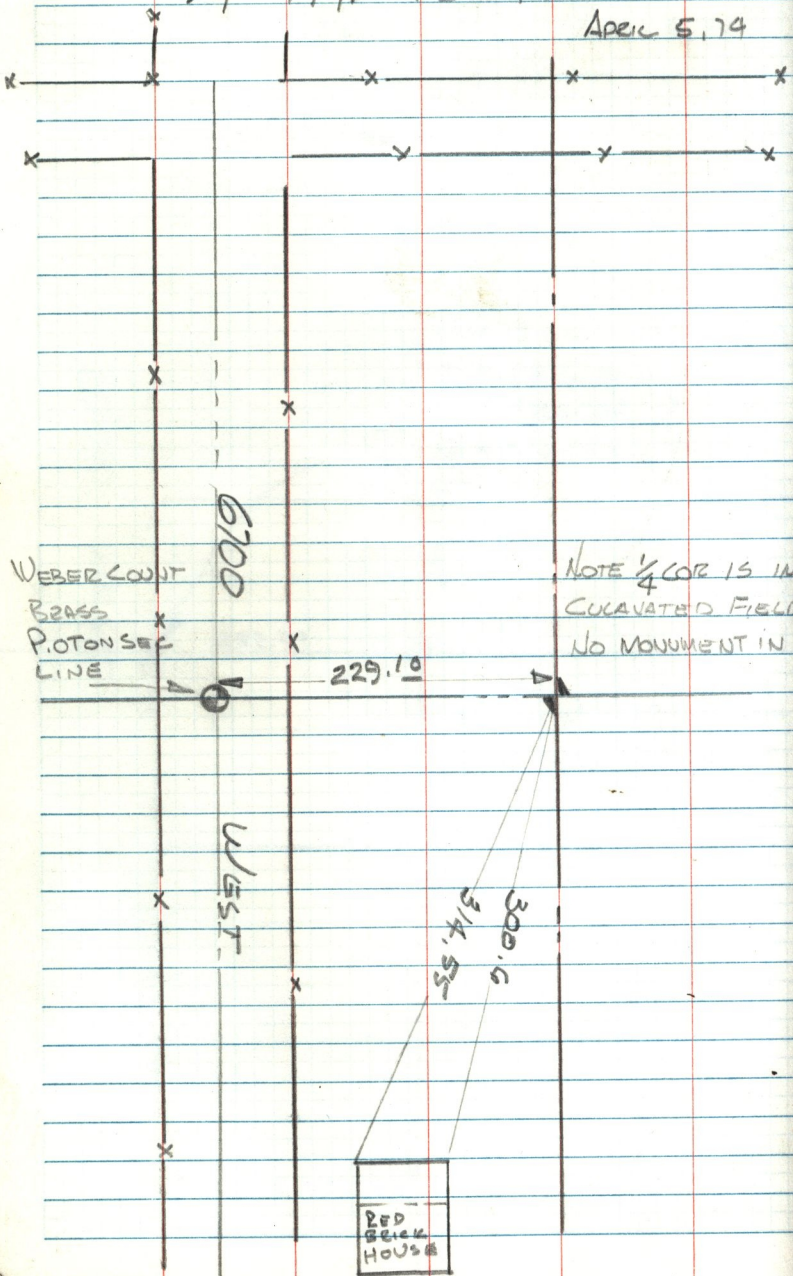

WEBER COUNT
BRASS
PION SEC
LINE

6700

WEST

229.10

NOTE 1/4 COR IS IN
CULTIVATED FIELD
NO MONUMENT IN

300.0
314.55

RED
BRICK
HOUSE