


$L = +1^{\circ} 06'$

$A = 1999.87$

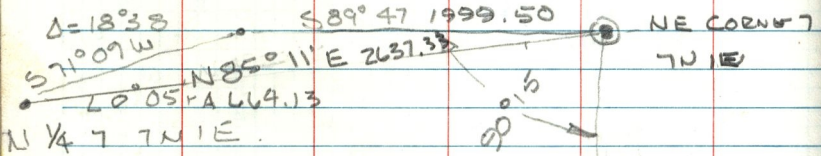

$A = 2634.14$
 $L = +1^{\circ} 15'$

E. 1/4 COR
SUC 7 7N1E

$\Delta = 27' RT$