


REF FOR NE COR SEC 7 T11E

~~Aug~~ Aug 1, 74

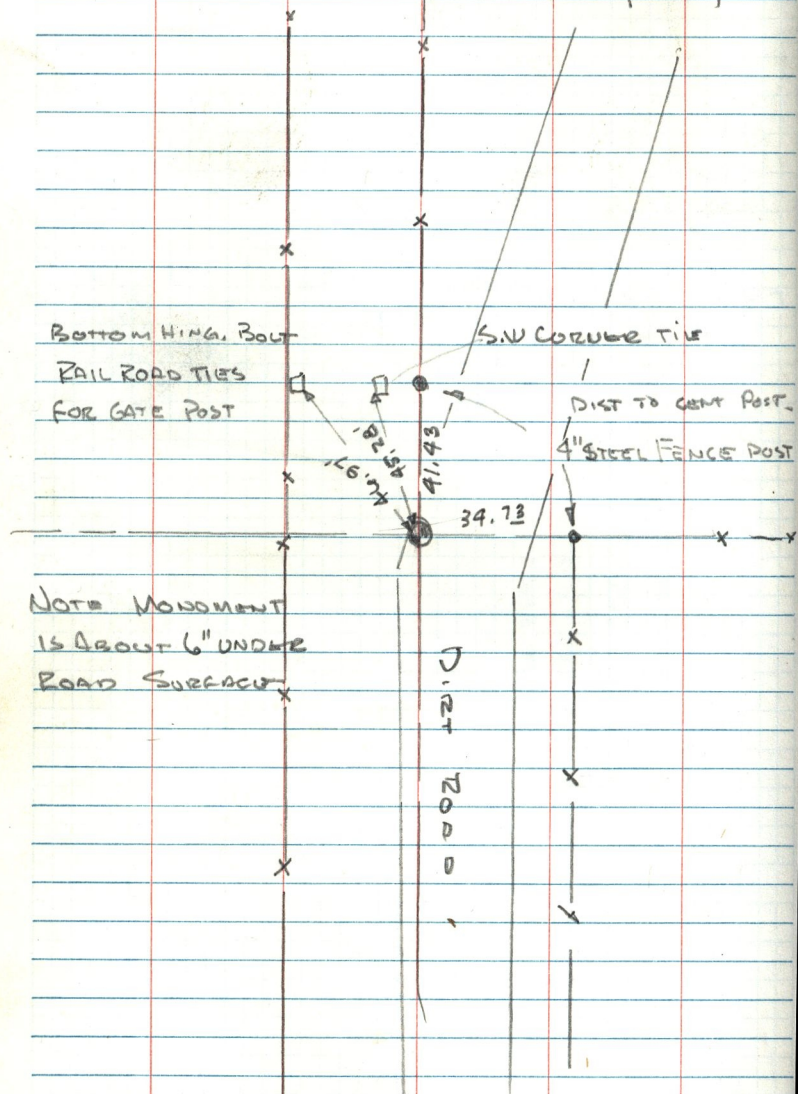

BOTTOM HING. BOLT  
RAIL ROAD TIES  
FOR GATE POST

S.W. CORNER TIE

DIST TO CORNER POST  
4" STEEL FENCE POST

NOTE MONUMENT  
IS ABOUT 6" UNDER  
ROAD SURFACE

DIST ROAD