


18'

START EDEN WATER EASEMENT
(NORTH) TO " " RESIVOIR

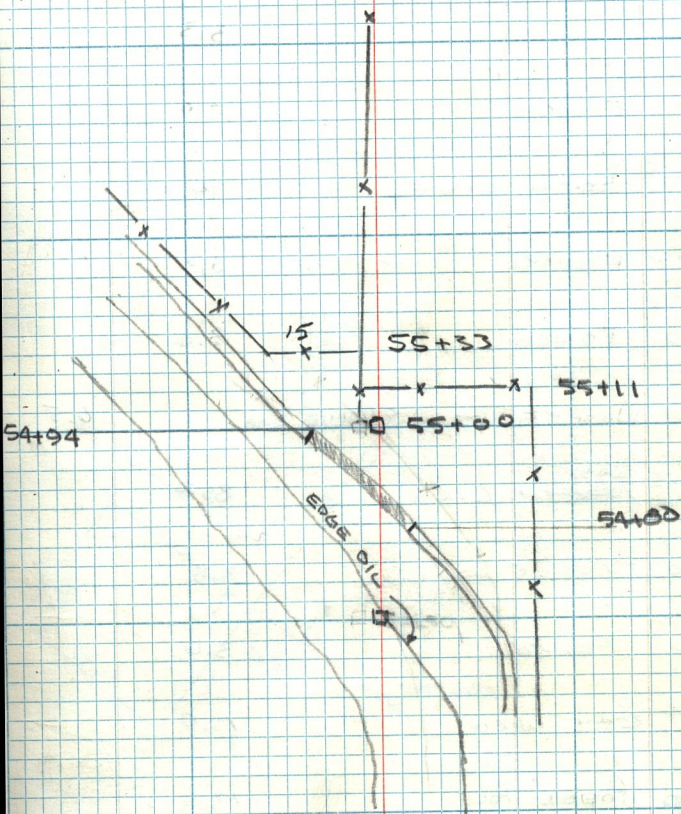

Note: From Stz. 55+33 ahead (North) make west side of pipe line easement 20 ft. west and parallel to Section Line.

6-6-73
NDI