


Rec 6012 SWL,

Nov 19, 24  
G.J.H.  
P.P.

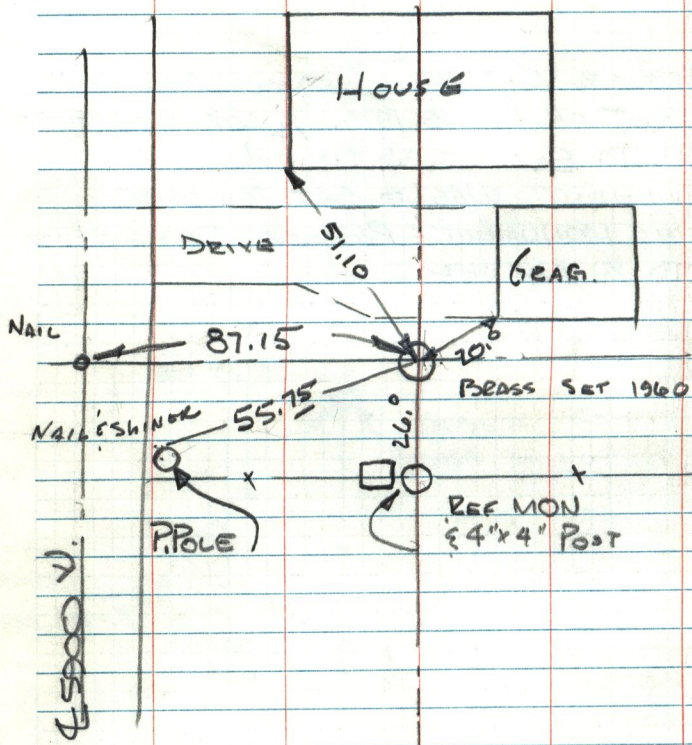

No. 192  
South West Sec 7 - South east Sec 1  
T 5 N R 2 W

|