

125.7 Veteran S. RR Spike + 116 ft



NW COR. ROW CLAIM

Sec. Line

170' ELEVATION

5198.39

Mon. Line Wash Blvd  
3861.69

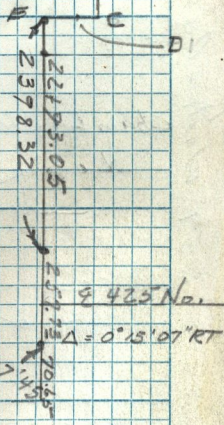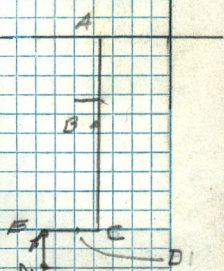

2824.39

Mon. Line  
No. Street.

4625.29