


Mtn. Road Traverse

Jan 20, 1975


6 x 180 = 1040

42.14 19.87

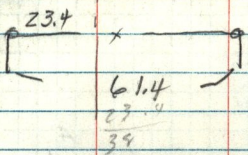

Stu Patterson T  
Bill Christensen  
Mike Daniels

Vert = 0°

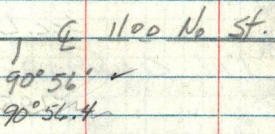

5.0° 59' W.  
2571.36


659 Wash = Address

Chain Link fence

canal

Grey Snake House

Edge oil  
Δ = 0° 30' Lt.

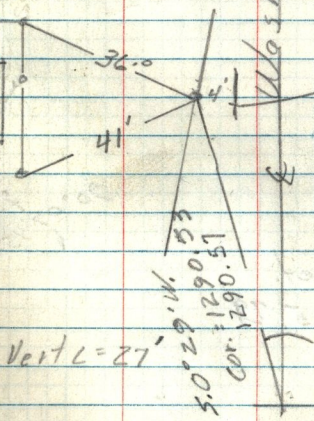

Vert L = 27°

90° 20'  
1 No. St.

