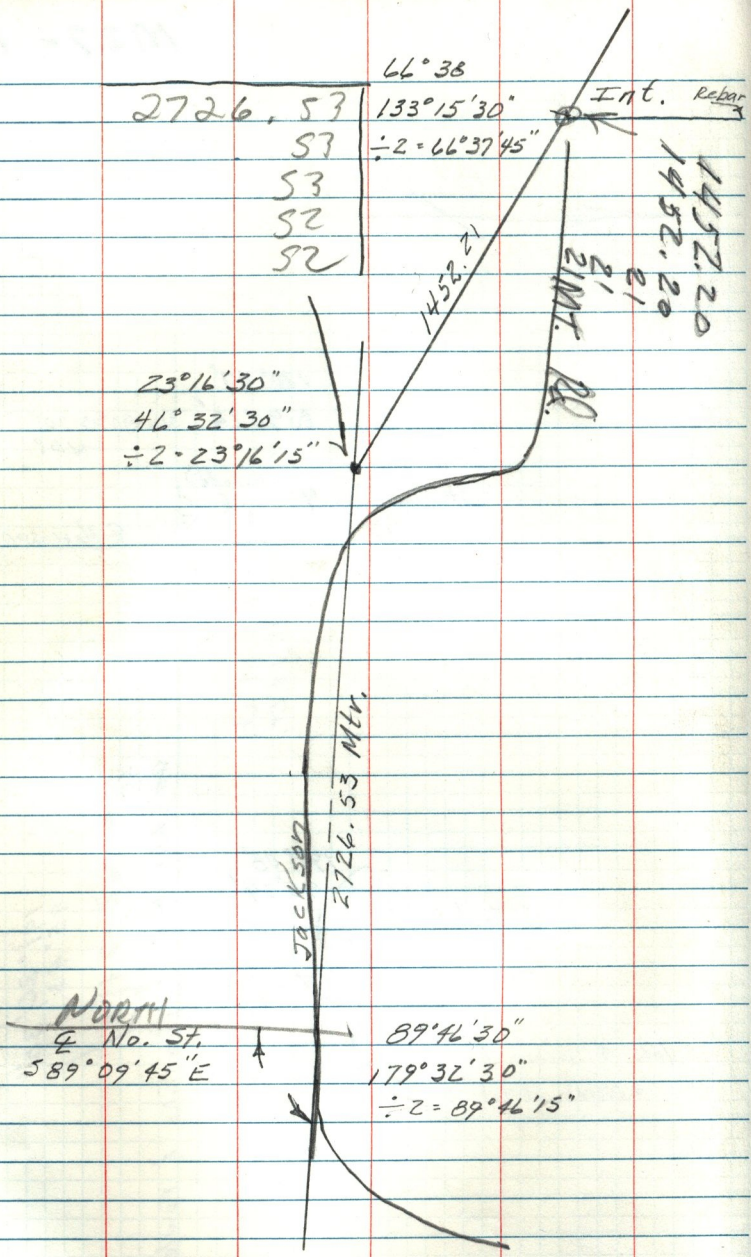
66° 38
2726.53
53
53
52
52
133°15'30"
÷2 = 66°37'45"
Int.
Rebar
1452.20
1452.20
1452.20
Int. Pt.
23°16'30"
46°32'30"
÷2 = 23°16'15"
Jackson
2726.53 Mtr.
North
℄ No. St.
S89°09'45"E
89°46'30"
179°32'30"
÷2 = 89°46'15"