1/4 Cor. T6N; R1W
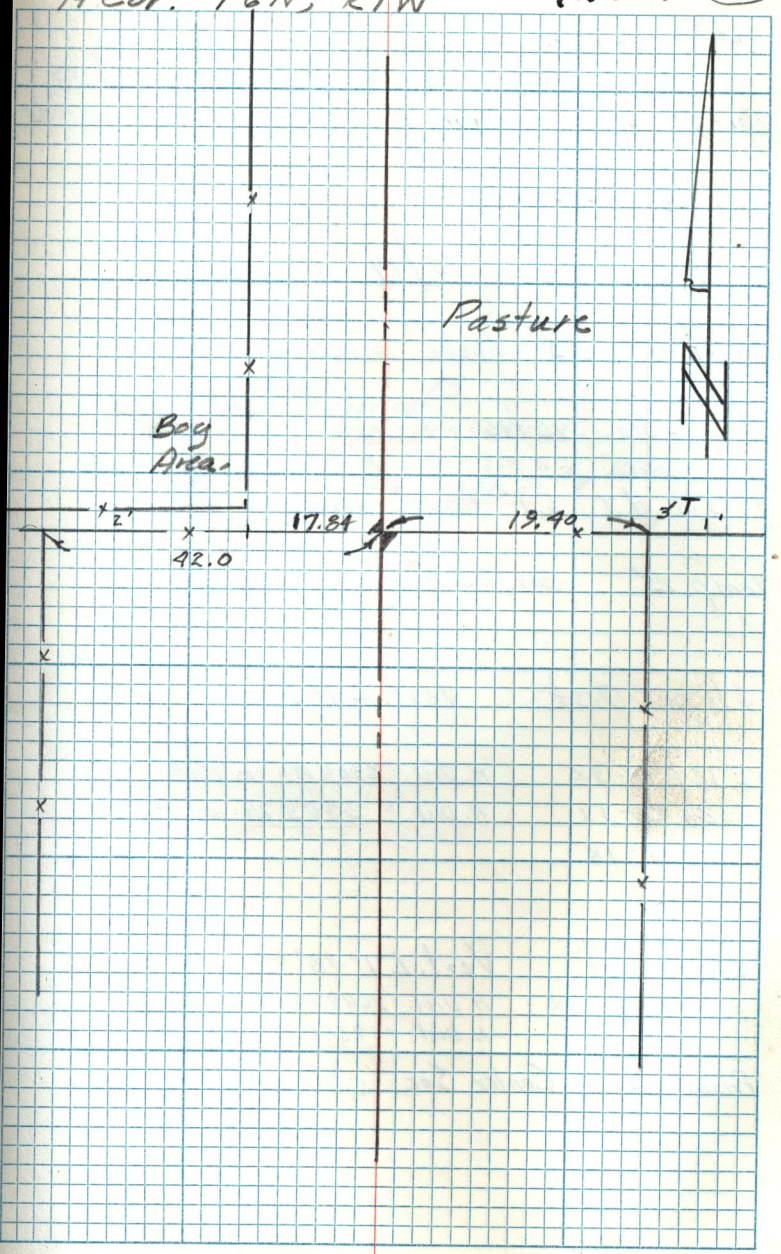
MC 27-22