


T 5N ; R 2W

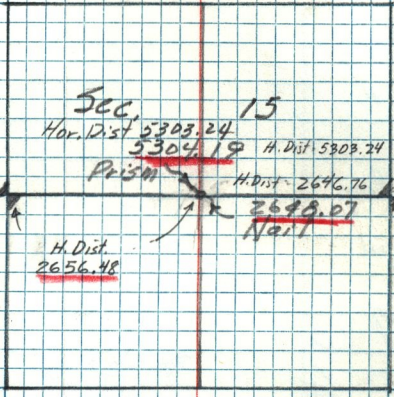

Sec. 15

Hor. Dist 5303.24

5304.19


Prism

Prism

H. Dist 2646.76


H. Dist 2656.48

Nail