


MC 27-24  
MC 63-75

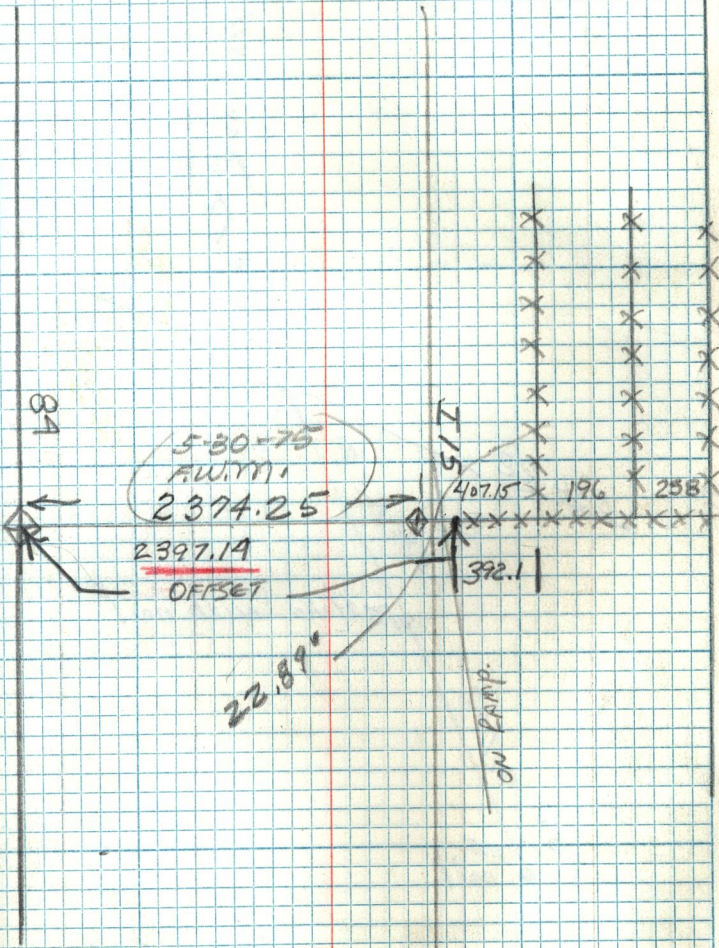

CANDAL  
ON HUN ESTIMATED CYCLE OF FENCE LINE