


13.56'

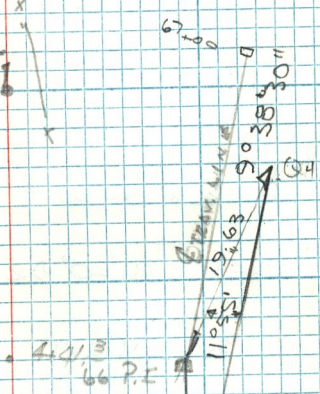

4.41 3/4  
66 P.I.



4+00

5.68+59



DEED LINE Y

65+00

