


SECTIONAL VIEW PERPENDICULAR TO PIER LOOKING WEST
SCALE 1/4" = 1'-0"

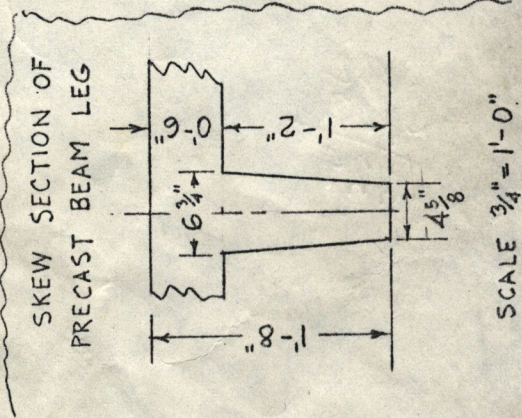

NORTH FORK BRIDGE
CR - 350(1)
11-29-72
ADP

12.11 1/4
9 10 10
13 1/4
3 1/4
4 5/8
2 8 3/8