

T 6 N R. 3 W,


1/4 CORN. COM TO SEC

15 14

22 | 23 6 N 2 W

22 23

JUN 4, 75

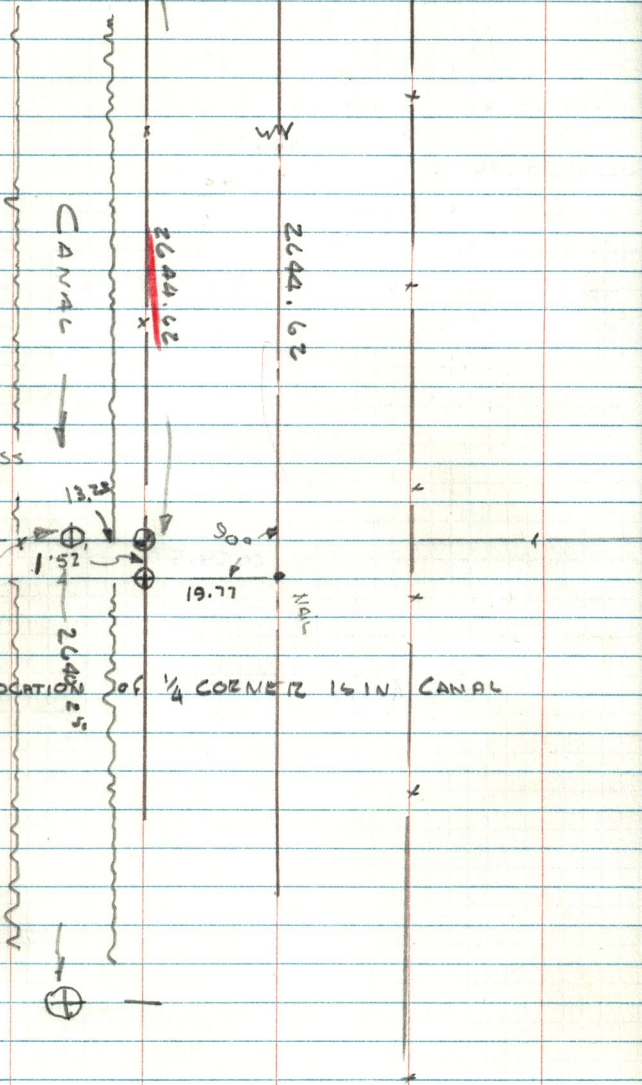

TRUE LOCATION of 1/4 CORNER IS IN CANAL

BRASS