


NORTH LINE 23 6N 2W

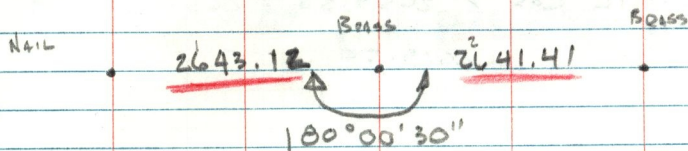

$$1 = V = 0^{\circ}14' \times 2610.16 = 2640.12 + 33 = 2643.12$$

$$2 = V = 0^{\circ}12' \times 2641.43, 2641.41$$