


8-26-75

PATERSON S.

CHRISTIANSEN W.

CRAKER S

REPLACED 1/4 SEC STONE MON.  
WITH CONCRETE + BRASS MON.

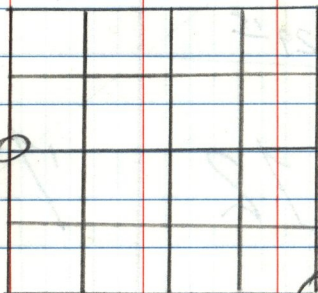

SW COR NW 1/4  
SEC 21

① 2  
2957