


WEST LINE SEC 14, T6N21W 1/122/76

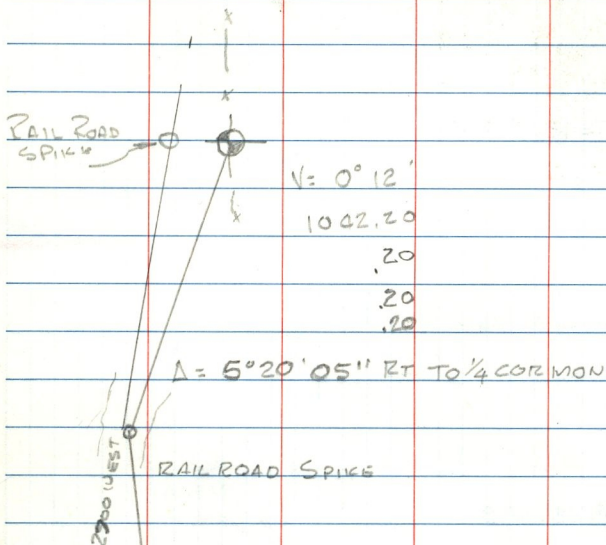

$V = 0^{\circ}06'$

$2^{\circ}07'30''$ ALT 1.1494, 99

USE $2^{\circ}15'06''$ ALT .99

.99

Co. BRASS 124

15	14
22	23

1 4' OFF SET.