


60 x .9 = 54"
 60 x .8 = 48
 74

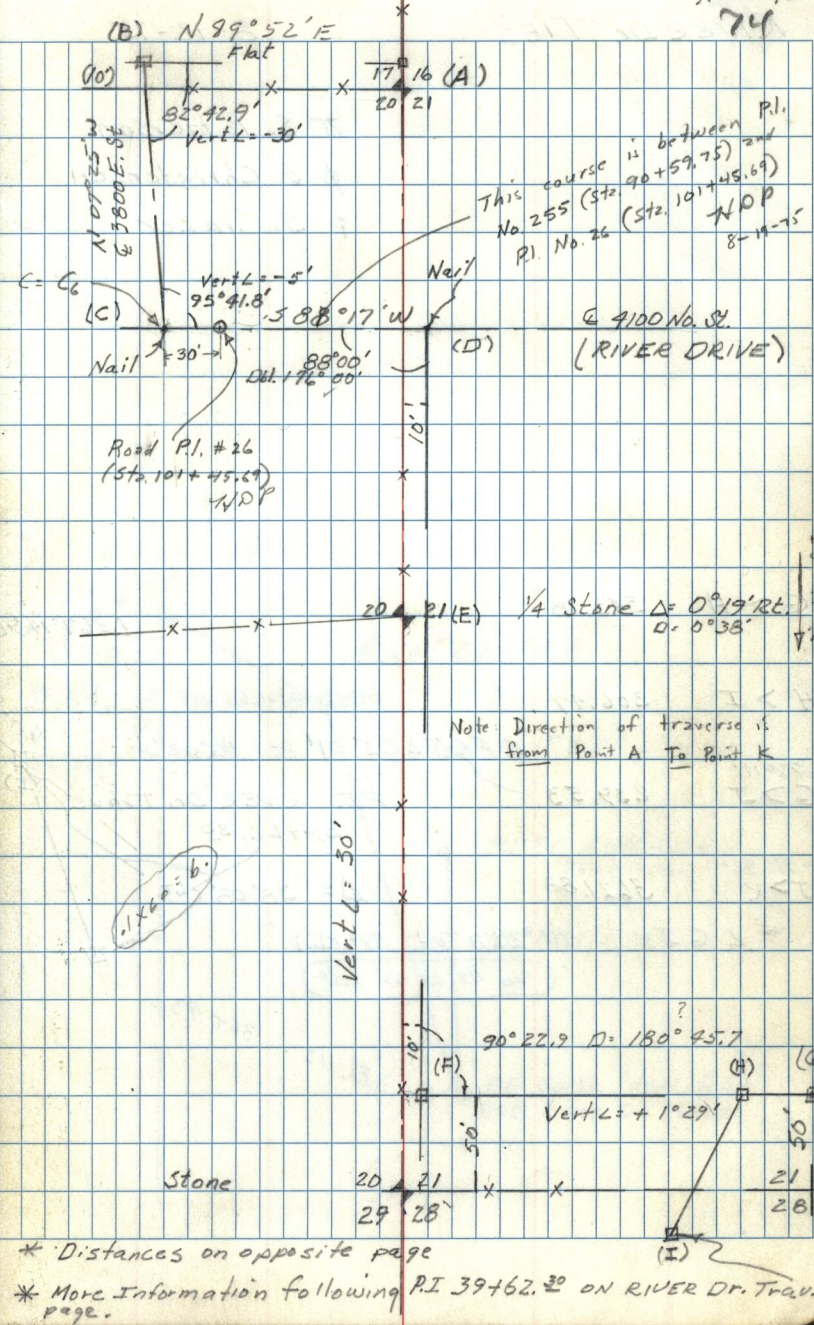

Direction of Traverse

* Distances on opposite page

* More Information following P.I. 39 + 62.30 ON RIVER DR. Trav. page.