


M37-34

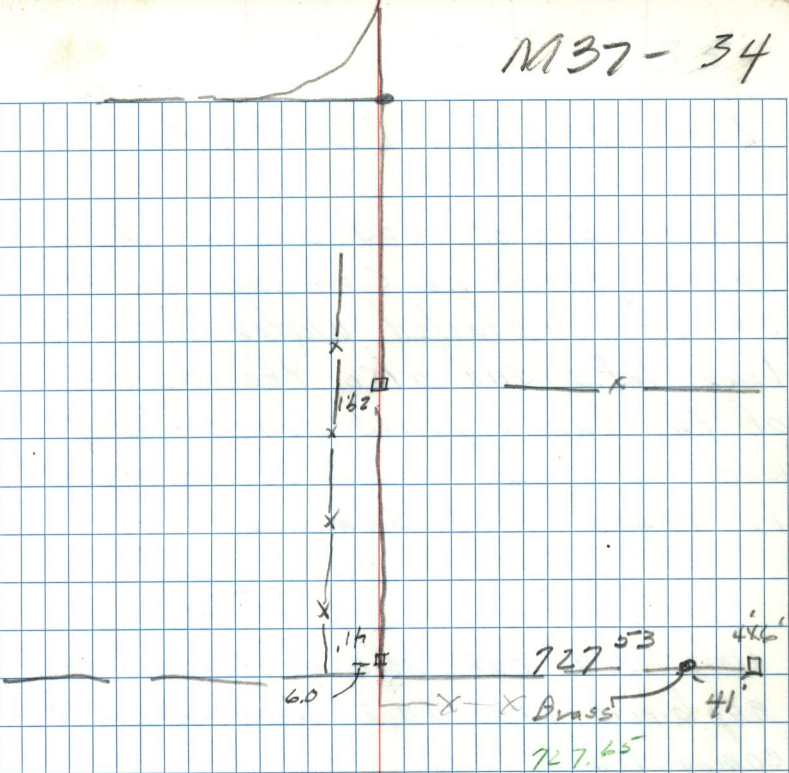

N