


4700

West

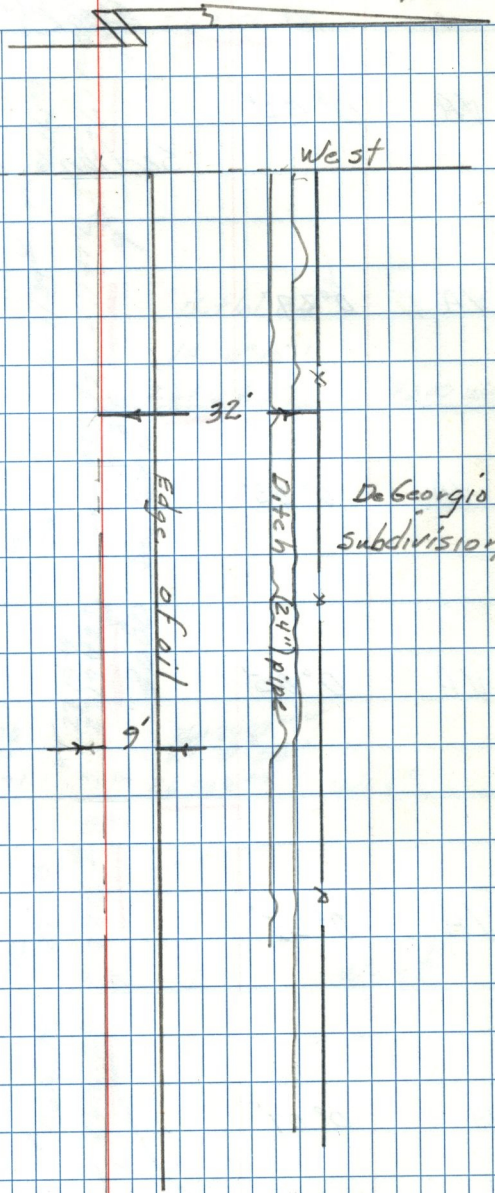

HWY

84