


Boo # 37

44

1-22-76

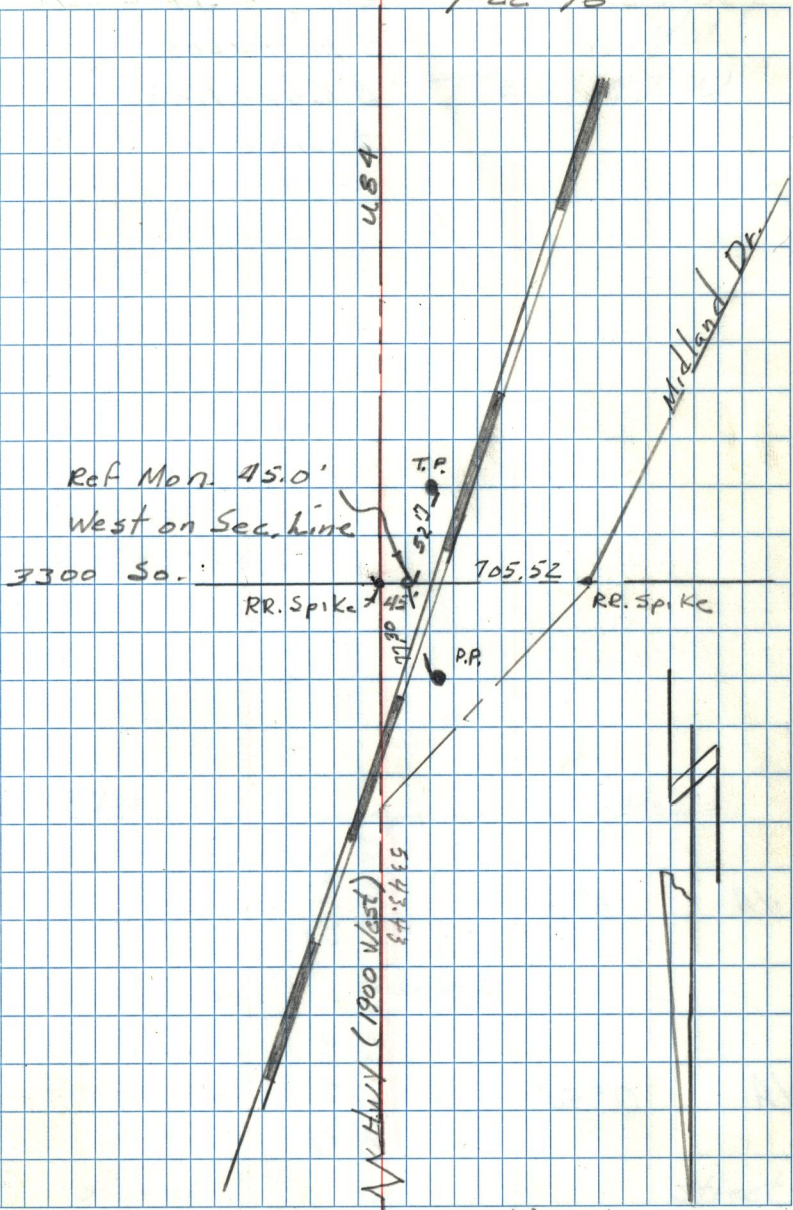

AK Hwy (1900 West)
54.265

T5NR2W

2 1