


MC-37-47

Roy City Monument

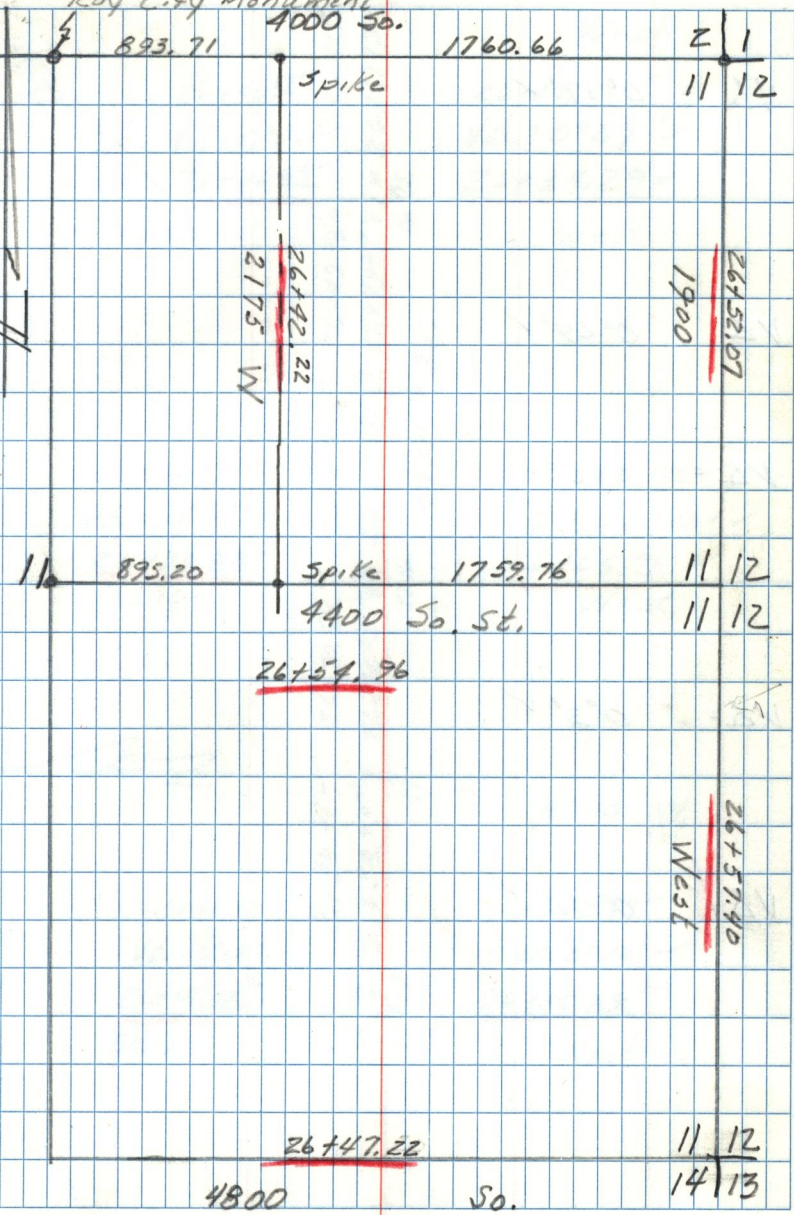

Note: These are corrected distances.