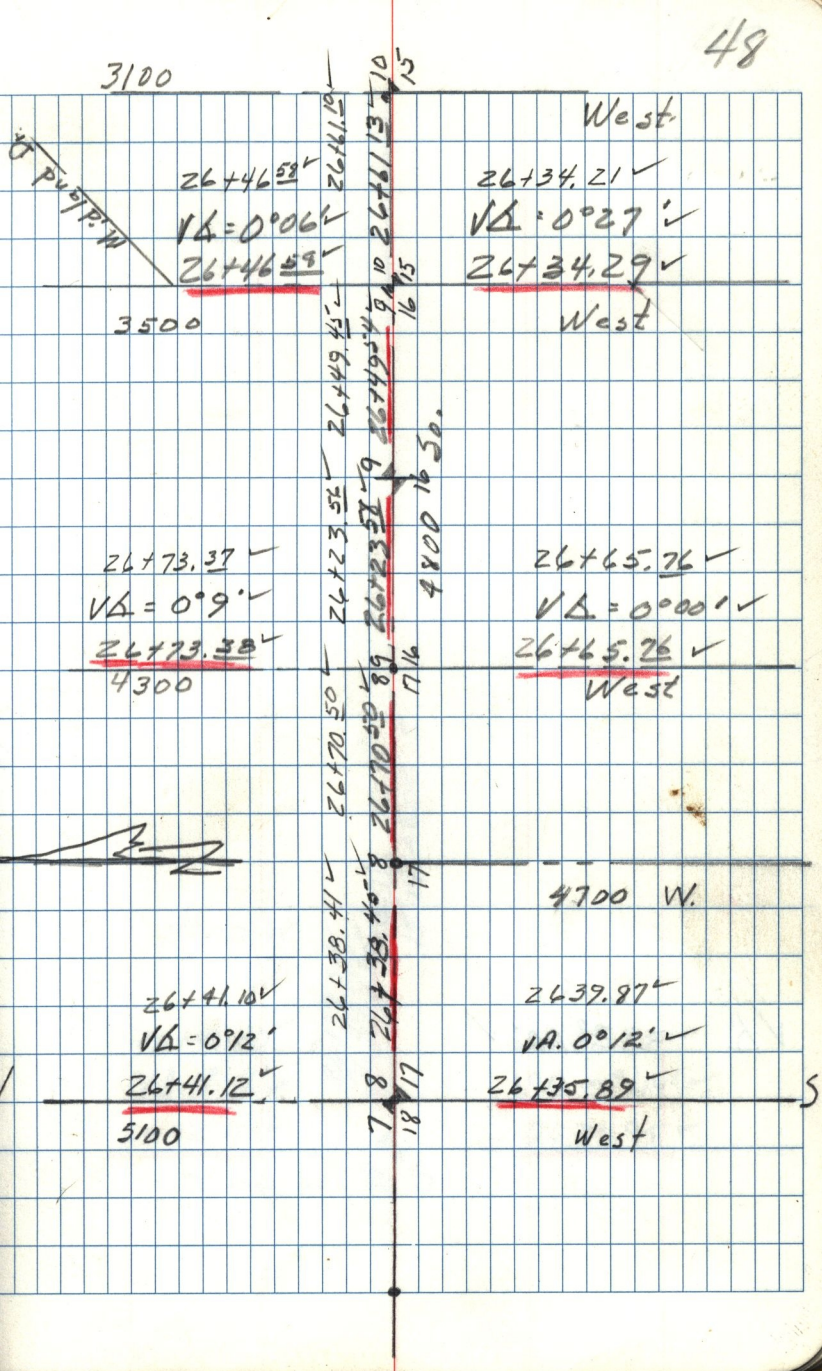
3100
West
26+46.58
VΔ = 0°06'
26+46.58
3500
26+34.21
VΔ = 0°27'
26+34.29
West
4800 to 50.
26+73.37
VΔ = 0°9'
26+73.38
4300
26+65.76
VΔ = 0°00'
26+65.76
West
4700 W.
26+41.10
VΔ = 0°12'
26+41.12
5100
26+39.87
VA. 0°12'
26+35.89
West