
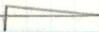


NORTH 

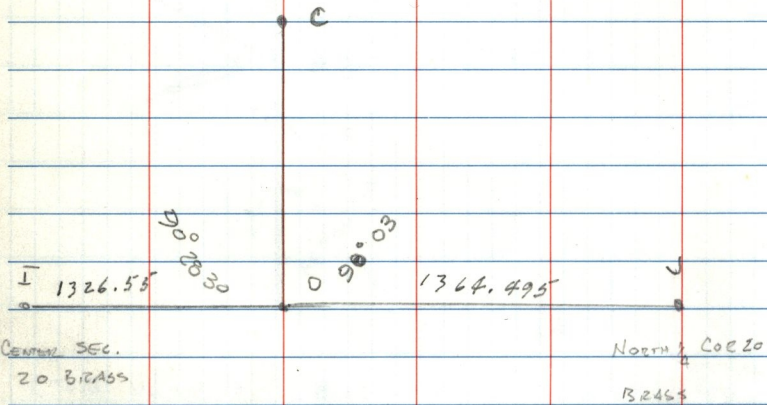

DTOI 0° 47	DTOL 0° 56
1326.68	1364.68
68	71
68	67
1326.55	65
	<u>1364.495</u>