


PART S.W. 1/4 SEC. 21, T. 7N. R. 1E.

7-8-80

CHECKING VERN JACK & FRED

52+80 ±

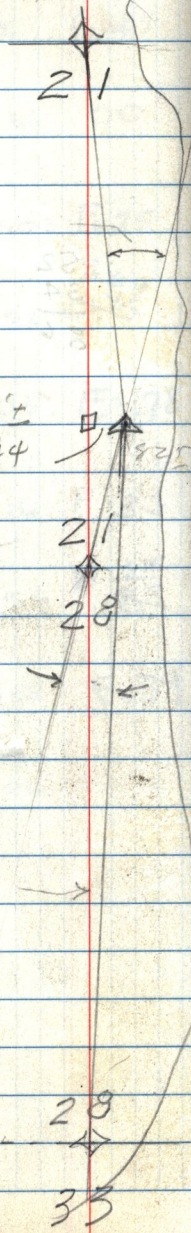

0°05'36"

1327' ±

1327' ±

0°00'12" 77.42 6.44

02°48"

0+00

10+64

17976

194

8

3°51'

N. 5°09'32" E

28

33