

CHRITIE CAR SURVEY

BEAUTIFUL DAY

FRED 9-1-78

BOB

DAUG

N 89° 53' W

151.01

249.50

DU

1749.36

#3

90°

RIVER DRIVE

51451.19

MON


160.46

2009

DU

6407.76' N

N 0° 07' E

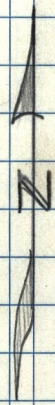

148.60



S. 1/4 Cor 0+00