


F.W.M., G.G. & JOHN REYNOLDS 9/26/78

N.E. COR. SW 1/4 SEC. 21,  
T. 7N., R. 1E.

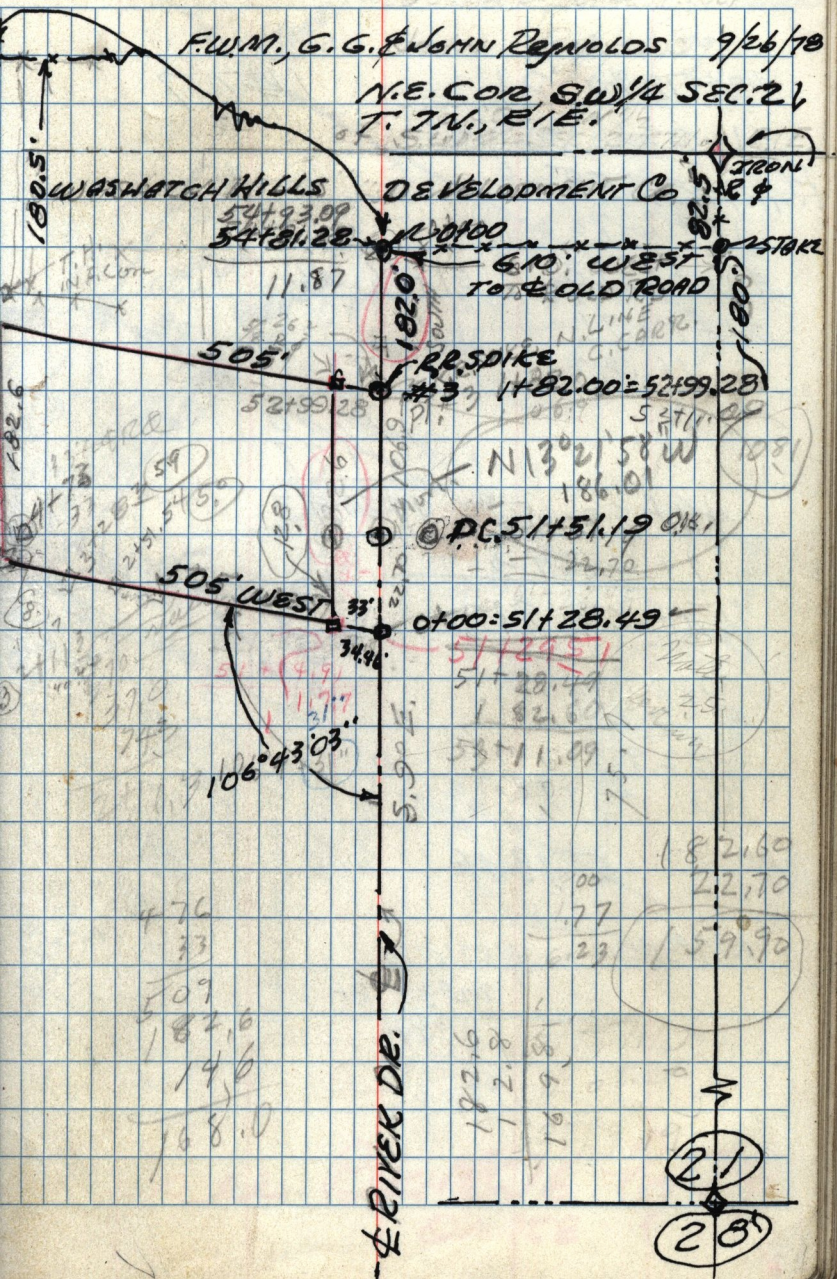

RIVER DR.

21  
28

476  
33  
509  
182.6  
146  
768.0

182.6  
12.8  
169.8

182.60  
00  
77  
23  
2,270  
159.90

N 130° 21' 58" W  
186.01  
P.C. 51451.19

0+00 = 51728.49

505' RR SPIKE #3  
1+82.00 = 52199.28

54931.28 11.87  
610' WEST TO OLD ROAD

DEVELOPMENT Co

WASATCH HILLS

180.5'

37001'  
518.8  
528.2  
528.2

182.6

STAKE