


FRED, JACK, BLAINE & VERNON

9/26/79

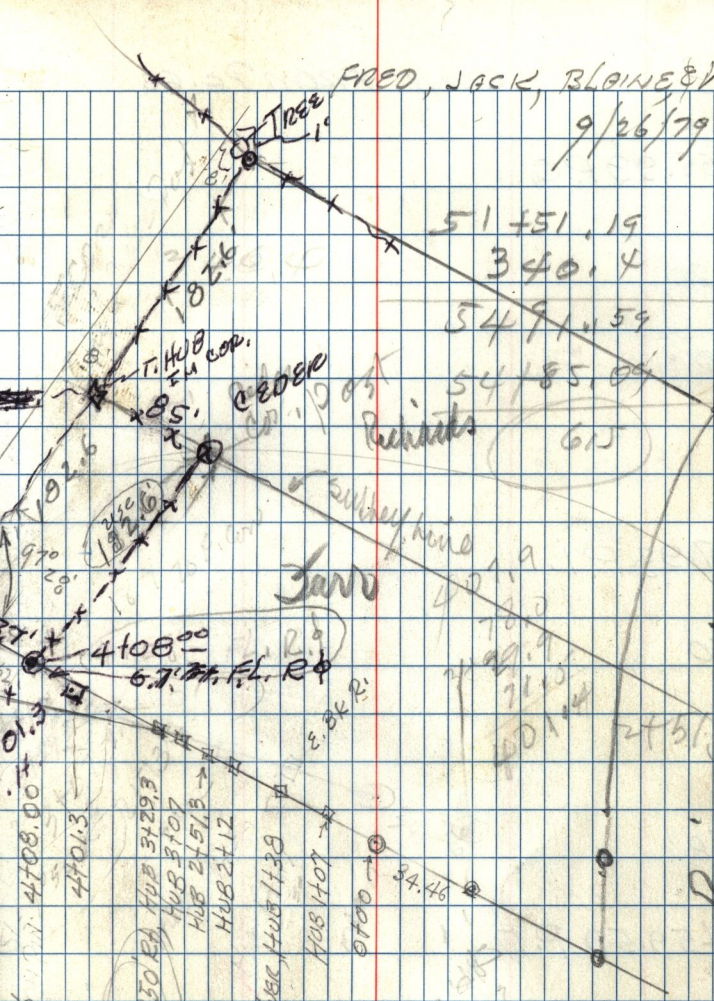

51 + 51.19  
 340.4  
 549.1 + 59  
 54185.04  
 615

4108.00  
 6.7.74, FL. R<sup>4</sup>

4108.00  
 4701.3

HUB 3107  
 HUB 2457.8  
 HUB 2412  
 HUB 1407  
 0100

E. B. R. E. SEC. 1407

34.46

4281.90  
 3129.3  
 162.40

see BK MC. 76 Pg 74  
 ORANGE