


10-6-78 CLEAR

REVERSE DRY

(5)

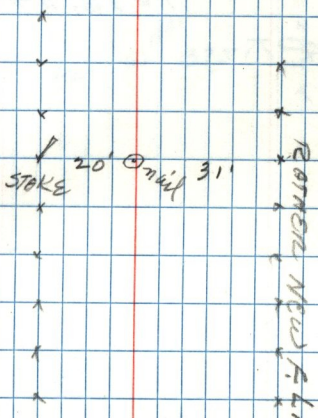

(4)

@ 20' 1/2"

@ 31.50'

(2)