

CONT. FROM PG. 41

CRUSTIE CAR 57

From to BEARING

SUNNY 10-19-78


COOL F. MALAN

R. LANGFORD T

SEE PAGE 41

RR SPIKE P.I. (3)  
RE-BAR

92 27 50'  
RAIL ROAD SPIKE

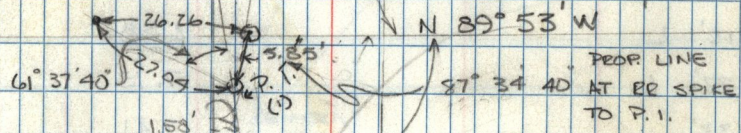

CHRISTIE CAR  
PROP

PROP. LINE AT  
RR. SPIKE TO P. 1.


(REWORKING)  
FINAL

Pg. 57


47  
95.78  
-1.5  
2.25  
1.37  
1.80

N 109° 51' N  
156.01

N 36° 23' 46"  
+ 75° 49'

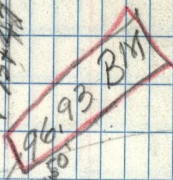

S. 55° 36' W

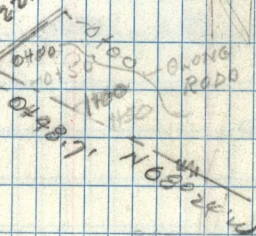

PL 33 + 26.81

PL 33

END OF LINE

(Cont Book MC 50-41)