


WEBER CO. SHERIFFS ASSEMBLY HALL.

7 MAR 79
CLOUDY 50% MC 4269
F.W.M.
J.R. CARVER
M. HOLMES

5600 S 2700 W

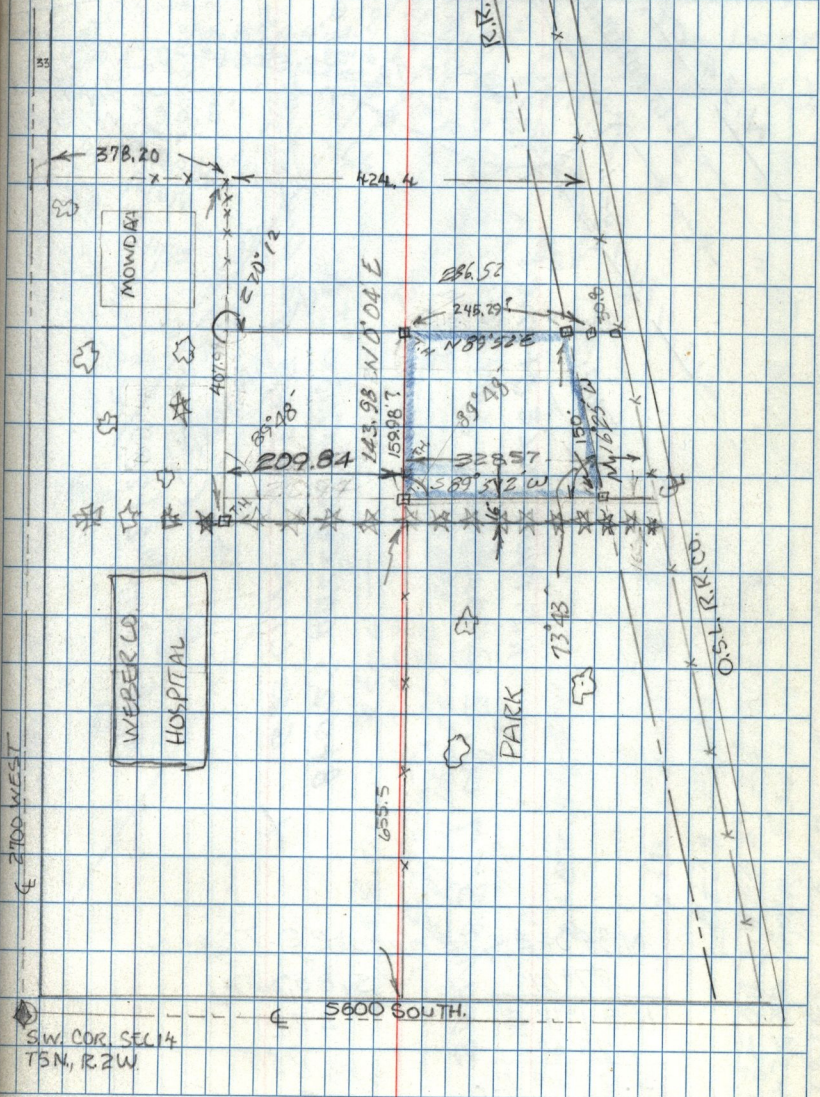

SW. COR. SEC 14
T5N, R2W