COUNTRY VIEW ELEMENTARY SCHOOL
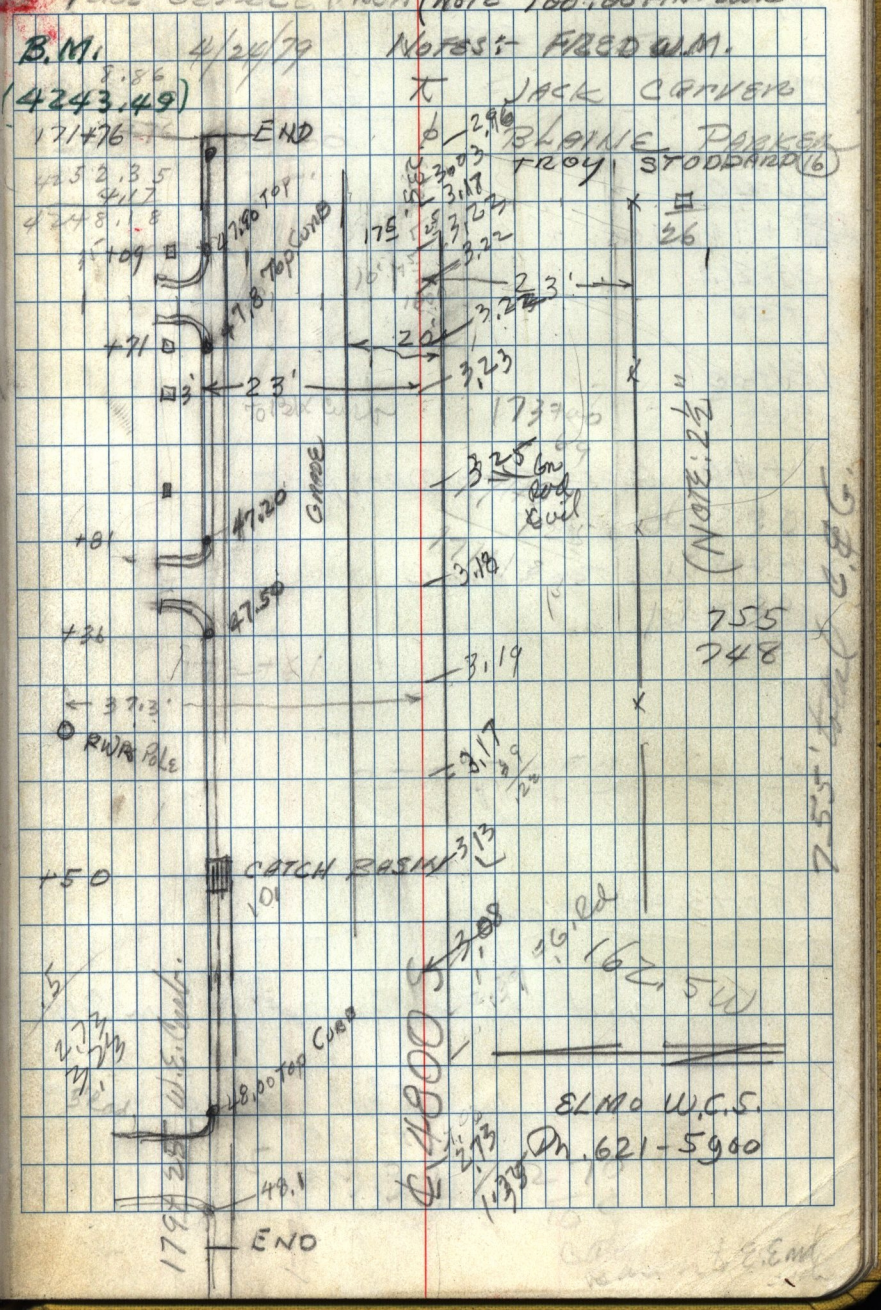
VEIL GESSELL ARCH. (NOTE 4249.00 = 100.00 FIN FLOOR