


GARDEN OF IDEX SUBD.

JOCK MILLER, FRED & DOUGLAS

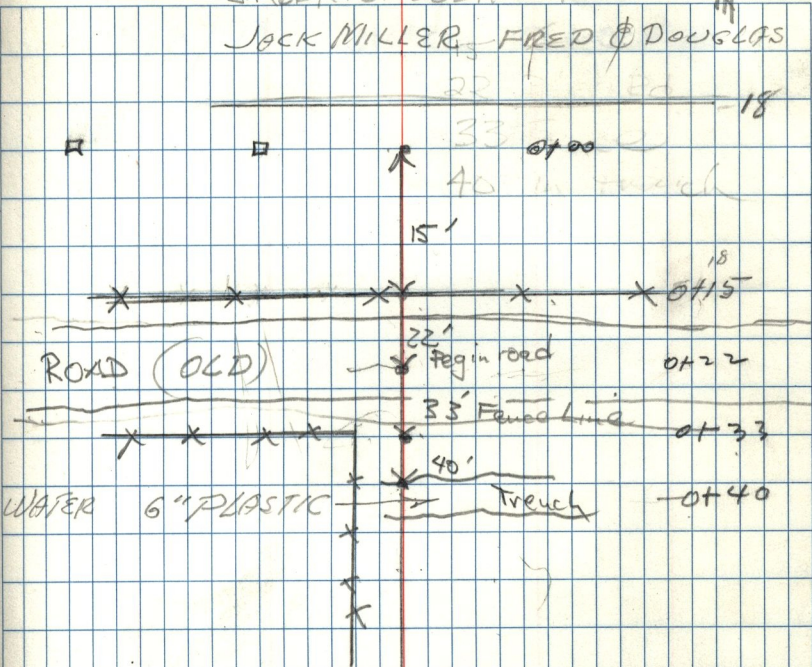

1936



2200 NORTH STREET

0+79 ↓