CONT FROM PG. 71

MC-42-75
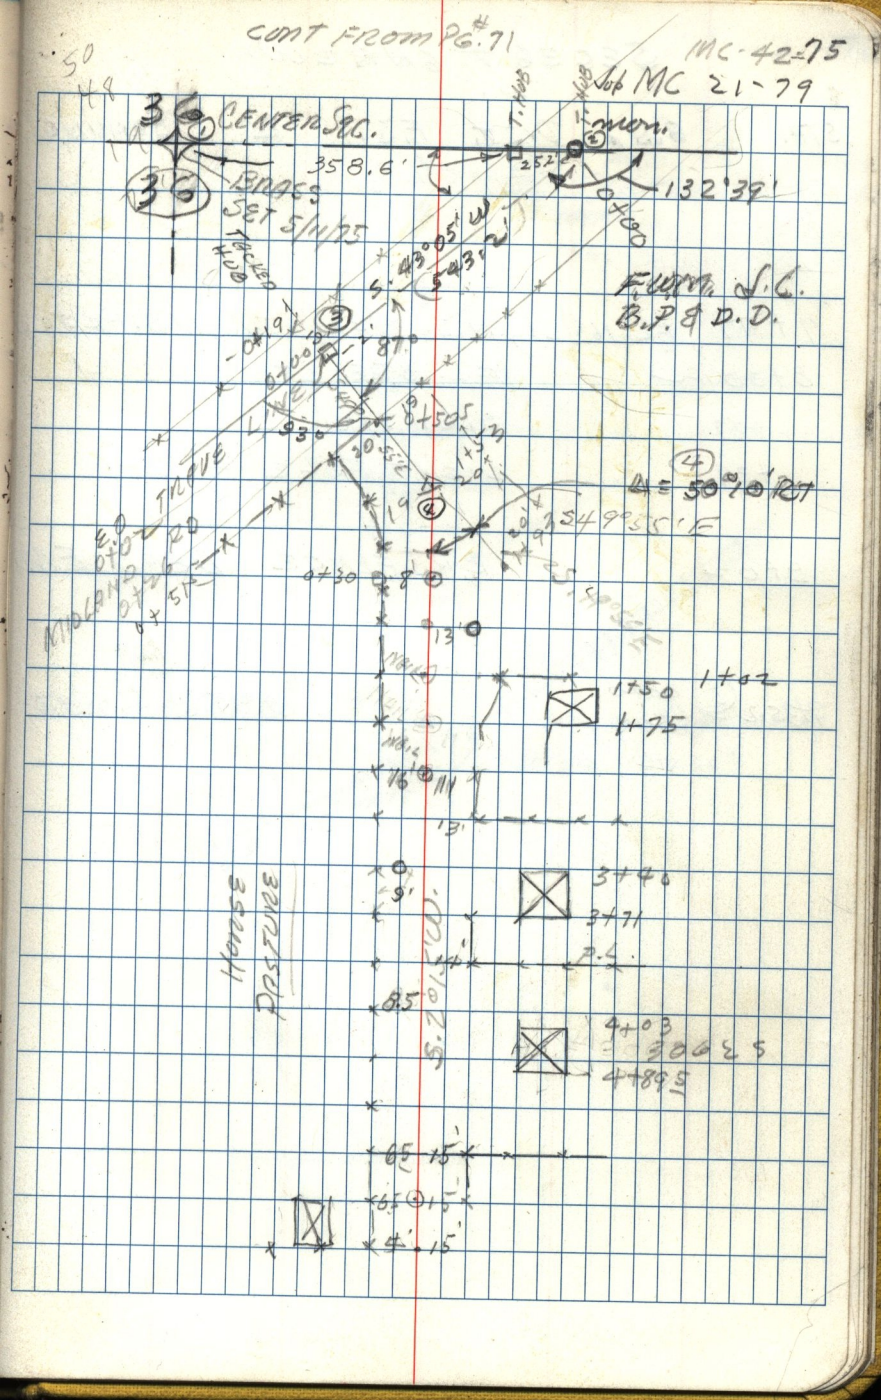
Job MC 21-79