

FRID

5-14-79

REBLIVE FORKE
54 PONTY FRED W. MALOR


WELLOCK CARVER

CH. DOUGLAS DUNBAR

5.206(2)



50'

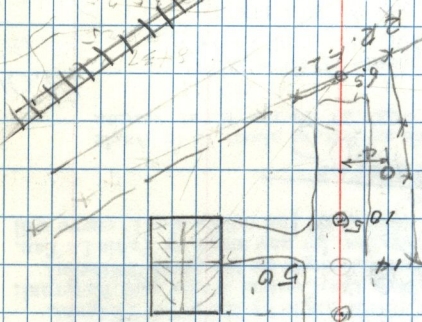

THIS ON N.S.R.R.

54 OR. SEC 1

U.P. R.R. TRUCK

SEE P. 4 - 1204.64?

$\Delta = 600'$ RT STAS 25

