



V.C. TRAIL TURNER  
 SEPT 21

P.I. # 4  
 202.73  
 73  
 73

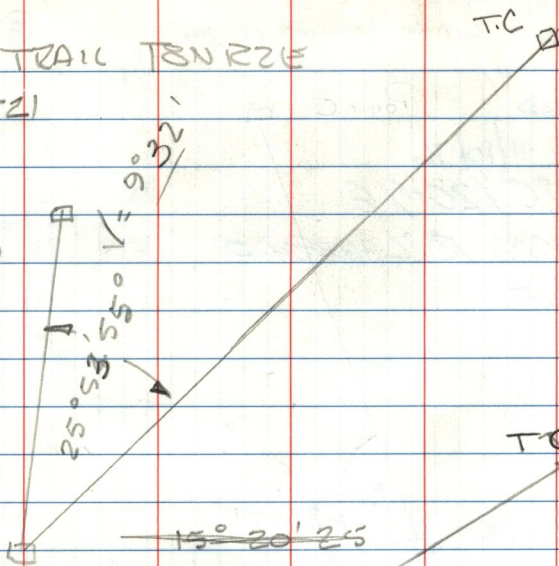

22.28  
 .28

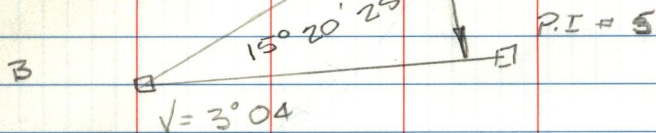

103.49  
 50

