


STAKE DRAIN ON EAST  
SIDE 5500 WEST AT 5050 SOUTH  
FOR RAY DUNN

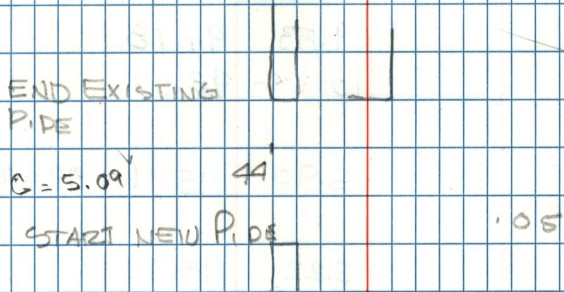

C = 4.93 ✓

C = 4.63 ✓

C = 4.64 ✓

C = 4.11 ✓

C = 4.81 ✓

C = 4.85 ✓

C = 5.49 ✓

C = 5.67 ✓