


DIVE 10, 77

ALL  
ARISE  
LIE  
OFF

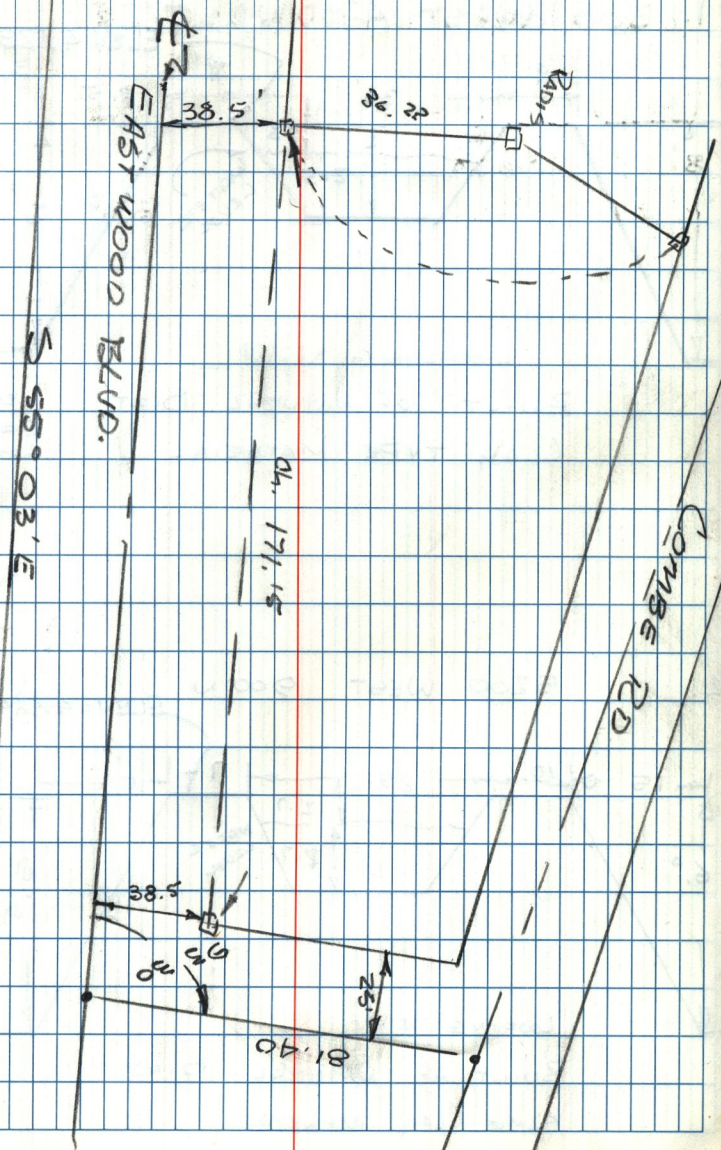

EASTWOOD BLVD.

$S 55^{\circ} 03' E$

38.5

171.15

1.40

2.5

38.5

$S 30^{\circ} 30'$

$S 30^{\circ} 30'$

COMBE RD