


X SECTIONS WARREN CANAL

FOR FLOOD STUDY


1. 300' WEST 4700 WEST

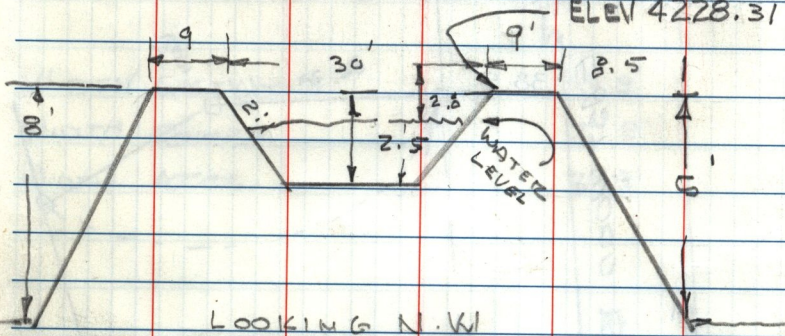

BUILT OF NATURAL DIRT
CLAY TYPE MATERIAL

ORIGINAL
GROUND
LEVEL.

2. 5200 WEST 900 W ELEV = 4224.97

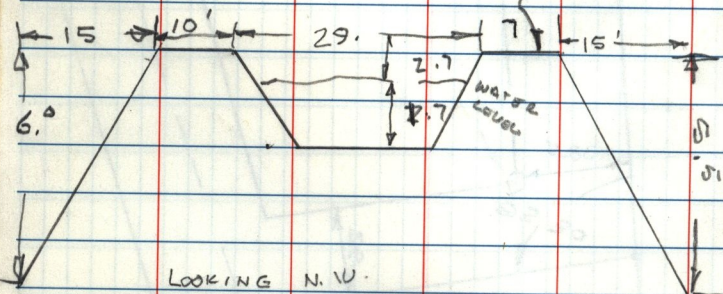

BUILT OF NATURAL DIRT
SAME CLAY MATERIAL