


TYPICAL
LOOK EAST ON

51

11.19

6

12.77

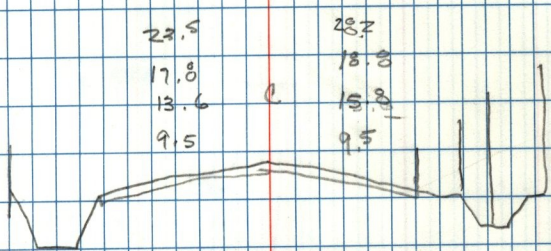

LOOK SOUTH ON

400 W