

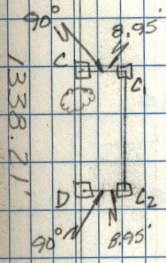


WEBER COUNTY PROP. LINE SURVEY (NORTH FORK)

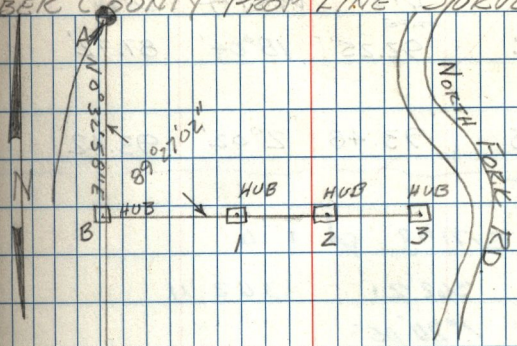

$N 0^{\circ} 32' 58'' E$

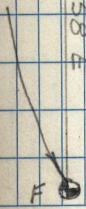

JUNE 30 1977  
 TEMP 85°  
 CLEAR & SUNNY  
 WYLIE  
 LANSFORD  
 BARNEY  
 McBEE  
 SULLY