



REF FOR Y IN NORTH FORK PACIFIC
NEW WATER LINE AUG 6, 77
G. Hill

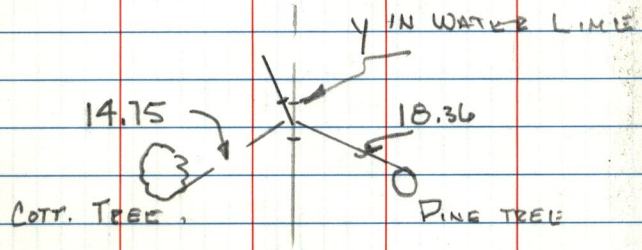

LAST SPRING AREA

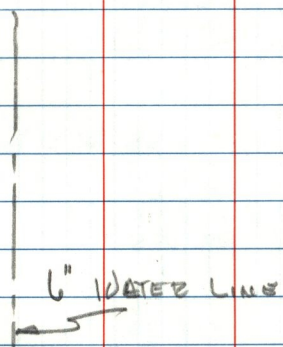

REF POINT ARE GUARD STAKE IN
TWO TREES.