


27 OCT. 1980

WEBER/CACHE CO. LINE CONTINUED MC 45-A

(31)

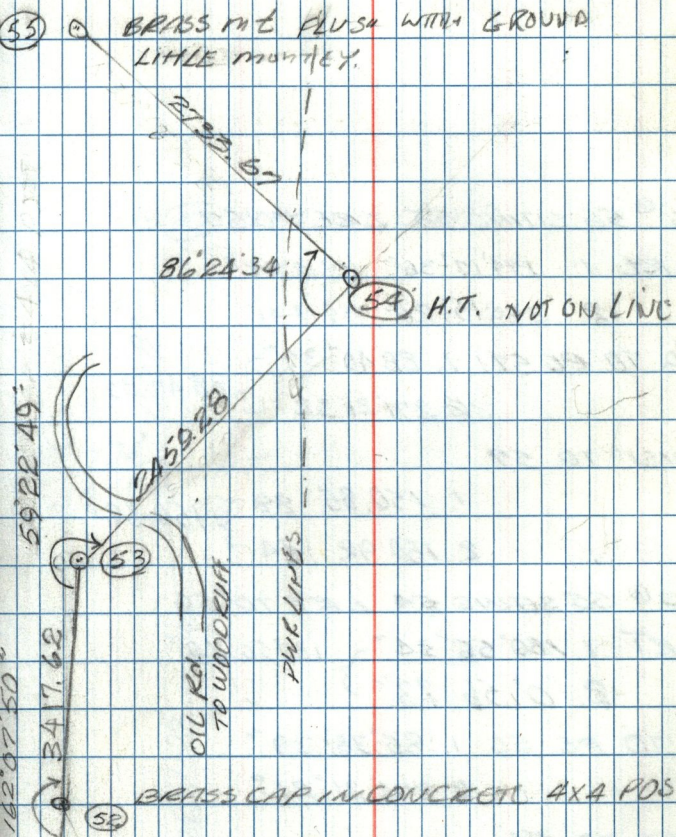

BRASS NAIL FLUSH WITH GROUND
LITTLE MOUNTAIN.


86°24'34.7
(54) H.T. NOT ON LINE


59°22'49

(53)

OIL FOR
TO WOODKUT


162.07

BRASS CAP IN CONCRETE 4x4 POST

(52)